


LEGEND

- Electric Valve
- ★ Master valve
- Rainbird Falcon Heads
- MR Rotator Heads
- ▲ Quick Coupler Valve (Zone 5, 10 and 14)
- Mainline
- Lateral Lines (Size noted on plans)

Contractor to include cost for relocation of irrigation line. Coordinate with Owner

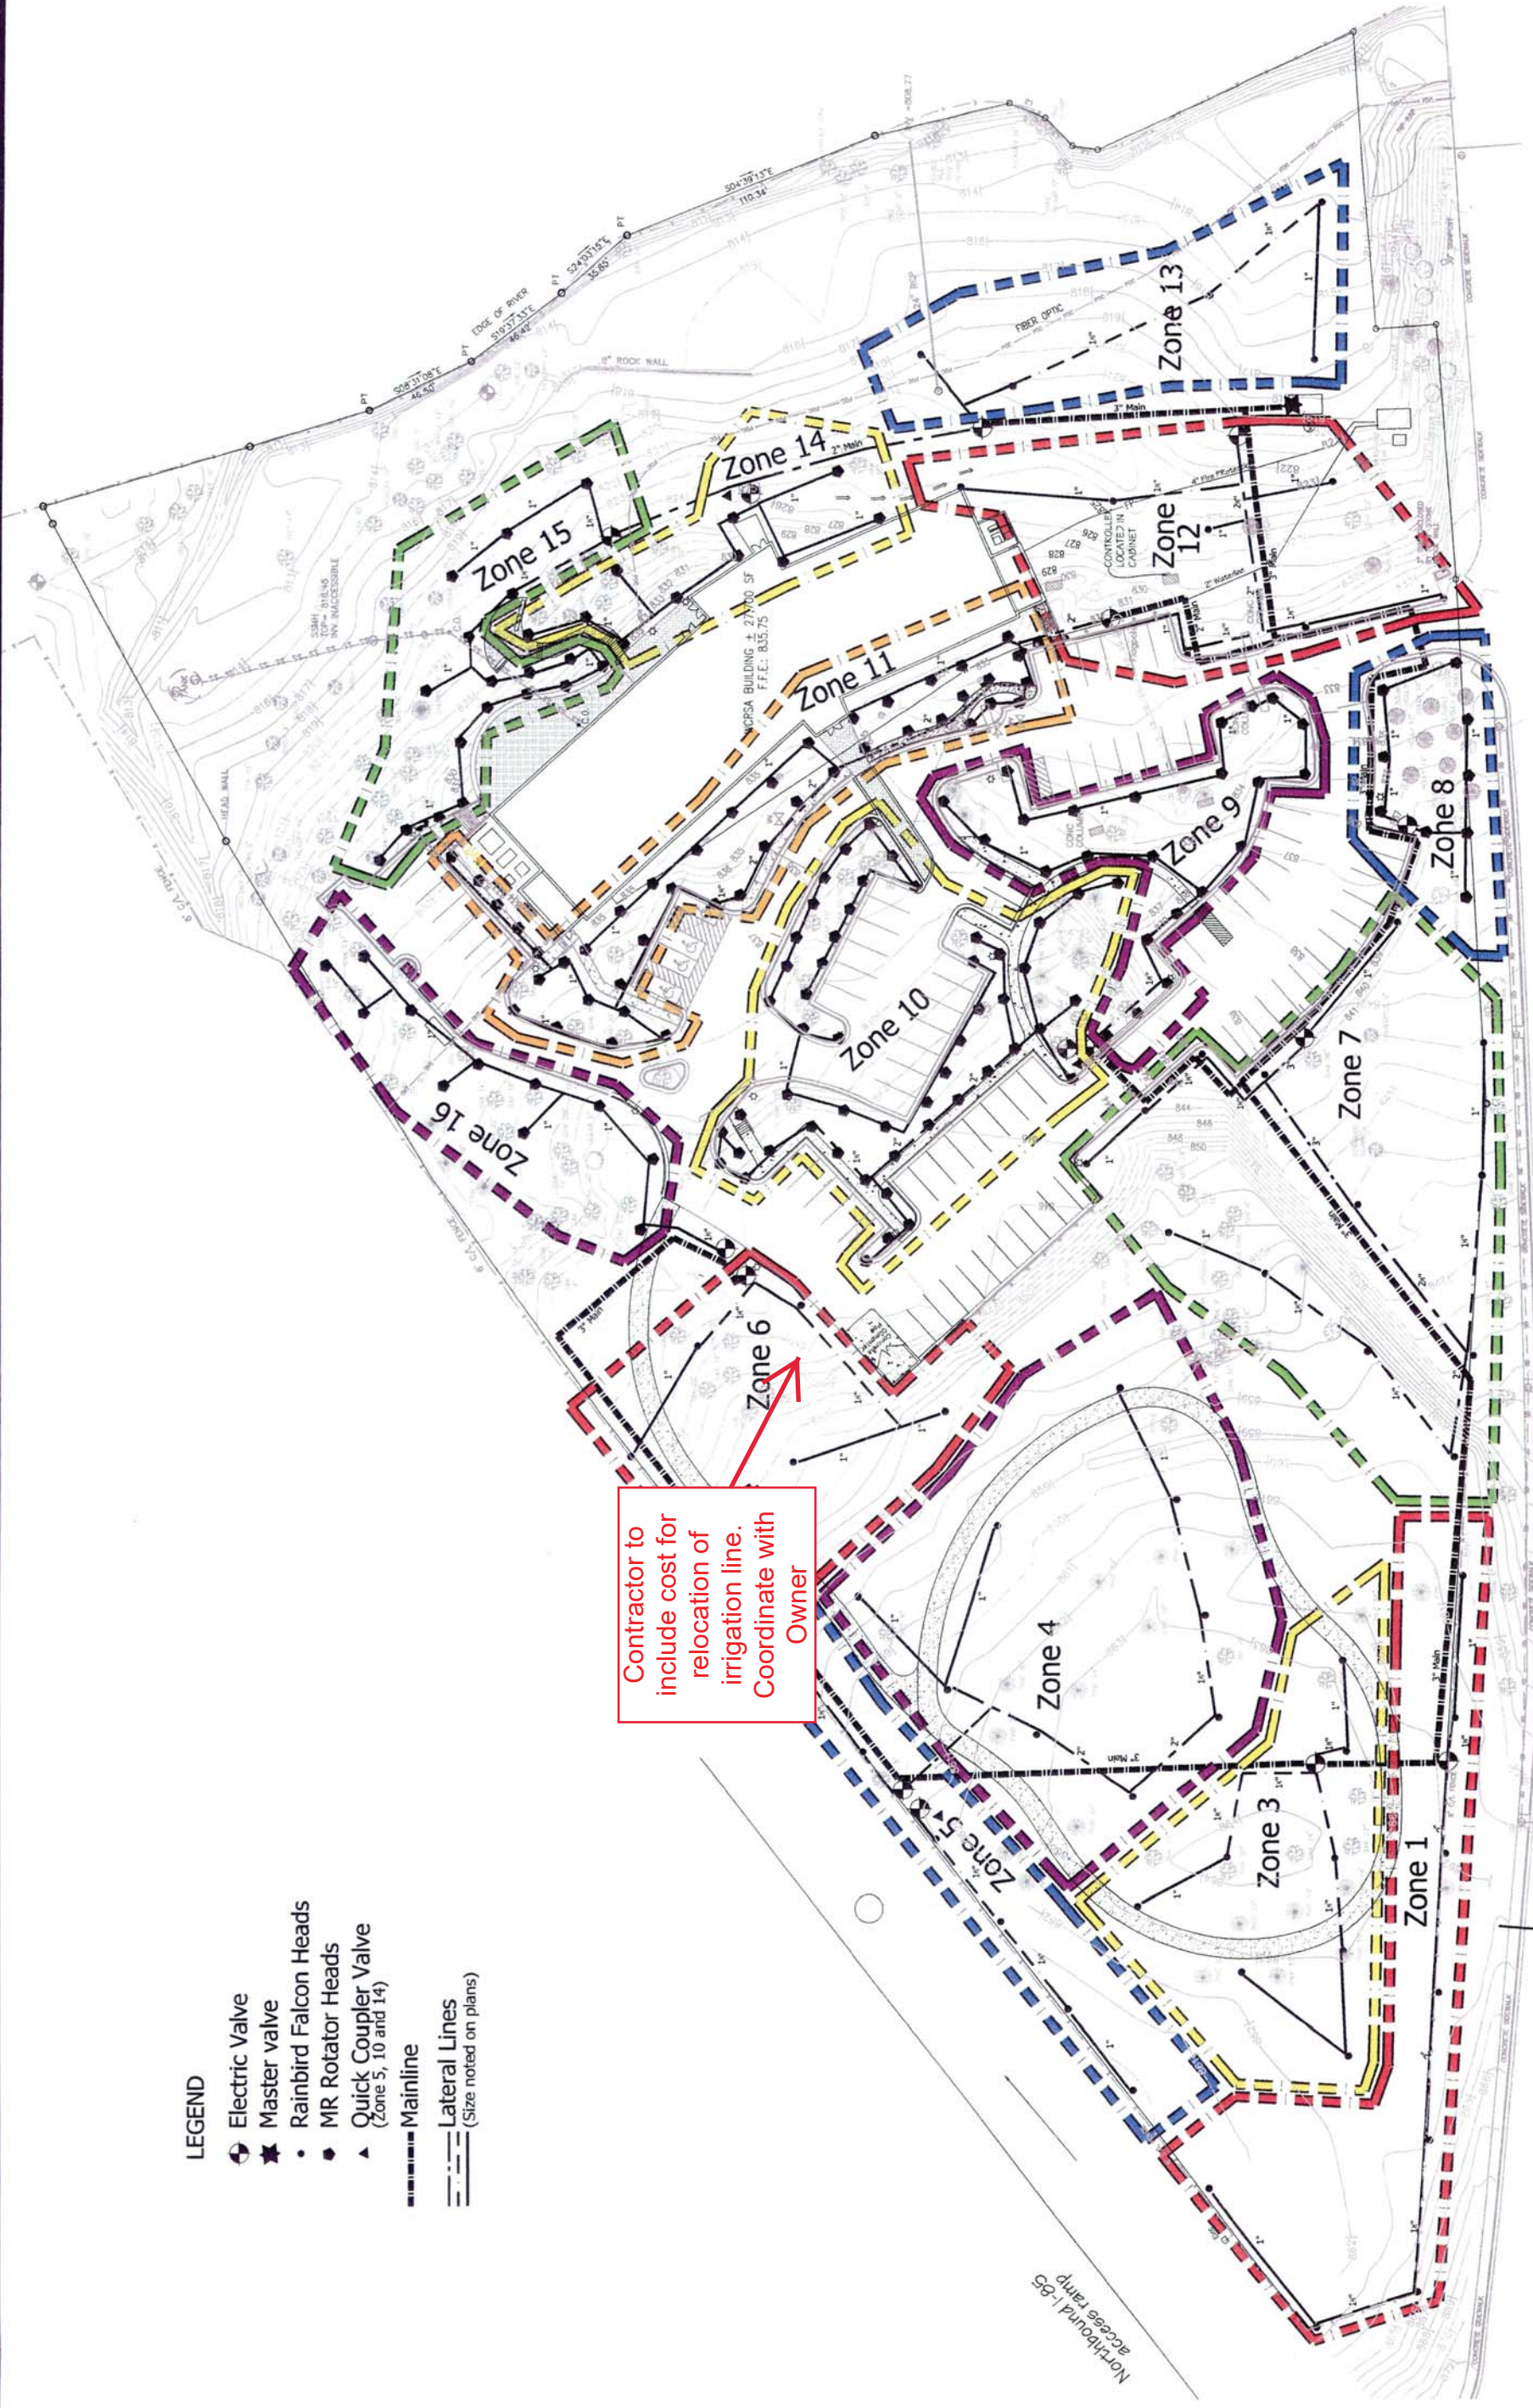

OCTOBER 2008
IRRIGATION AS-BUILT
 WillowTree, Inc Easley, SC 864.859.2888
 mobile # Patrick Moore 864.304.3067